




110 SE 6th St., Fort Lauderdale, FL 33301

110Tower.com


Suite 3000  
8,615 rsf



As Built

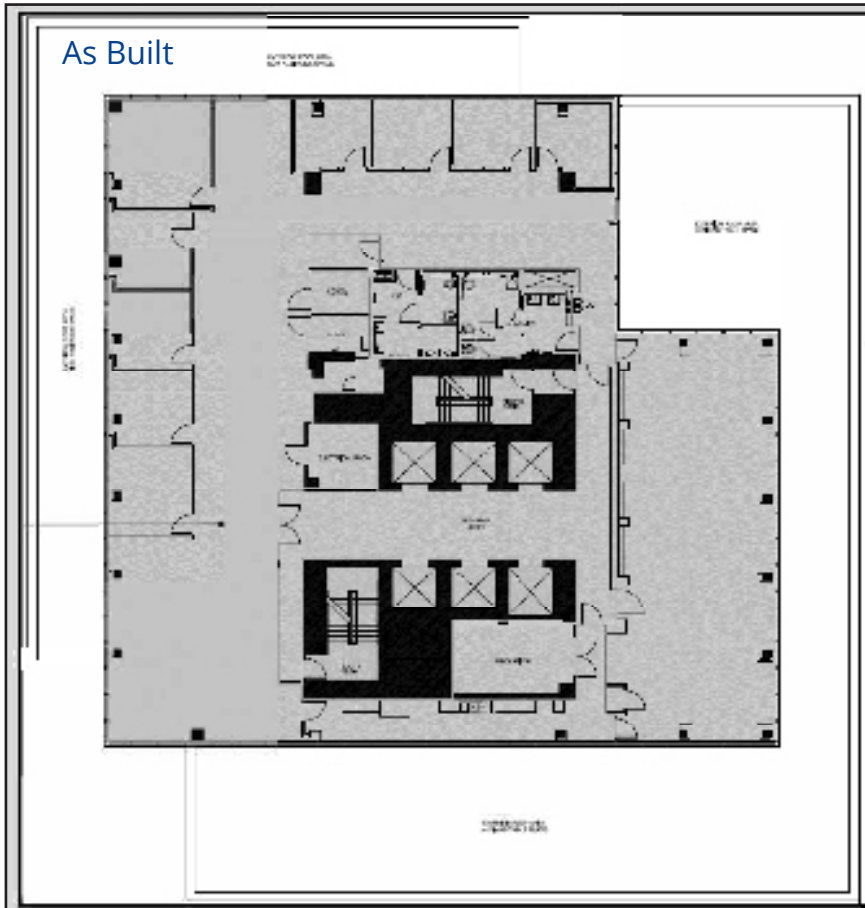

Spec Suite

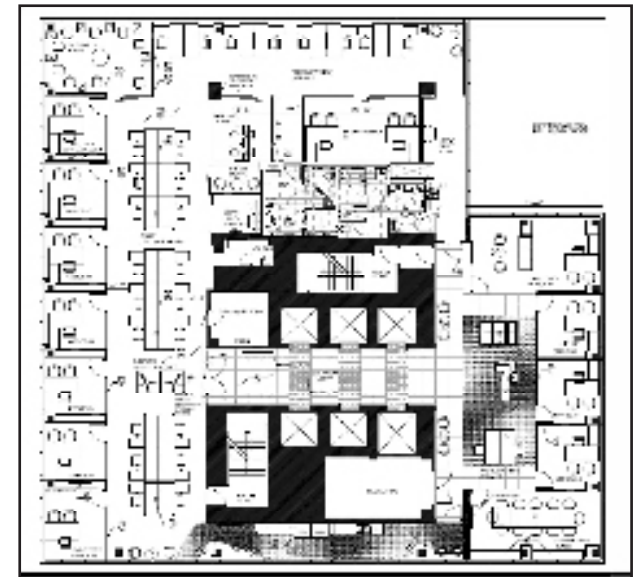

954 652 4610 Jonathan Kingsley  
954 652 4617 Jarred Goodstein

